

# Application for Connection to Wannon Water Roof Water Harvesting Scheme and Notification of Connection to Warrnambool City Council Stormwater

## PROPERTY DETAILS

Insufficient information will result in the return of applications. If you cannot provide all the property details, then a locality plan showing dimensions of property frontage and distance from nearest street intersection must be attached to this application.

Street No: \_\_\_\_\_ Street: \_\_\_\_\_ Town: \_\_\_\_\_ Postcode: \_\_\_\_\_  
Lot No: \_\_\_\_\_ Subdivision Plan No: \_\_\_\_\_ Crown Allotment: \_\_\_\_\_ Section \_\_\_\_\_

## PROPOSED WORK

Type of work (please tick ALL applicable boxes)

- New Connection to Wannon Water Roof Water Harvesting  
 New Connection to Warrnambool City Council Stormwater

## PROPERTY OWNER DETAILS

Name: \_\_\_\_\_  
Postal Address: \_\_\_\_\_ Postcode: \_\_\_\_\_  
Phone: \_\_\_\_\_ Mobile: \_\_\_\_\_ Fax: \_\_\_\_\_ Email: \_\_\_\_\_

*I hereby make application to Wannon Water for consent to connect to Wannon Water Roof Water Harvesting Scheme at the property described above.*

Signature of Owner (or Agent) \_\_\_\_\_ Date of Application \_\_\_\_/\_\_\_\_/\_\_\_\_

## PLUMBER DETAILS

Licence No or Company: \_\_\_\_\_

Name: \_\_\_\_\_ Phone/Mobile: \_\_\_\_\_  
Business Name: \_\_\_\_\_ Fax: \_\_\_\_\_  
Postal Address: \_\_\_\_\_ Email: \_\_\_\_\_

## OFFICE USE ONLY

## AQUARATE PROPERTY ACCOUNT NO:

**CONSENT** On signing by a Wannon Water Authorised Officer, consent is given to the Owner for undertaking the work described above.

NAME (of Authorised Officer) \_\_\_\_\_ DATE of CONSENT \_\_\_\_/\_\_\_\_/\_\_\_\_

SIGNATURE (of Authorised Officer) \_\_\_\_\_

## INSPECTIONS OF THE PROPERTY CONNECTIONS

### DATE

### INSPECTED BY

- Wannon Water Sewer Connection \_\_\_\_\_/\_\_\_\_/\_\_\_\_  
 Wannon Water Roof Water Harvesting Scheme Connection \_\_\_\_\_/\_\_\_\_/\_\_\_\_  
 Warrnambool City Council Stormwater Connection \_\_\_\_\_/\_\_\_\_/\_\_\_\_

Comments: \_\_\_\_\_

Completed forms can be emailed to [info@wannonwater.com.au](mailto:info@wannonwater.com.au)

Apr 2014

**wannonWATER**


PO Box 1158  
Warrnambool VIC 3280  
Ph: 1300 926 666 Fax: 03 5565 6050

[www.wannonwater.com.au](http://www.wannonwater.com.au)

## CONDITIONS of CONNECTION to Wannan Water Roof Water Harvesting Scheme

1. A site plan showing the Building Roof Line must be submitted with this application.
2. The Owner's Agent (Licensed Plumber) must give Wannan Water one business day's notice of intention to connect to each of the sewer main, roof water harvesting system and stormwater system to allow the connections to be inspected by Wannan Water prior to being backfilled.
3. Roof Water Harvesting pipework to be Sewer uPVC SN6 solvent cement jointed pipe for below ground pipework. Above ground pipework to be stormwater solvent cement joint. All joints from spout to below ground pipework must be water tight.
4. Pressure tested to ensure water tightness as per AS3500 Part 2 - Sanitary Plumbing & Drainage (Section 13).
5. Below ground pipes are to be laid with green marker tape:  
**'CAUTION - Roof Water Harvest Pipe buried below - no connections allowed'**
6. Laid on grade from the downpipes to roof water collection pipe connection point for the property and bedded on 75 mm sand with the bedding sand to surround pipe with at least 75mm depth
- 7 Minimum cover as per AS3500 Part 2 - Sanitary Plumbing & Drainage (Section 3.7)
8. Riser at connection point is to be 'finished off' with a screw cap, complete with 'O' Ring seal; located between 300mm and 400mm below finished ground level.
9. An 'As Constructed Plan' of the on-site underground works and connection works shall be submitted to Wannan Water within ten (10) working days of completion of the works. The plan shall be clear and legible and shall include:
  - a. Measurements & Ties
  - b. Inspection Openings & Shafts
  - c. Underfloor Drains (if applicable)
  - d. Outline of Block & Building
  - e. North Point & Road Names

### Example of Detail Required for the 'As Constructed Plan'

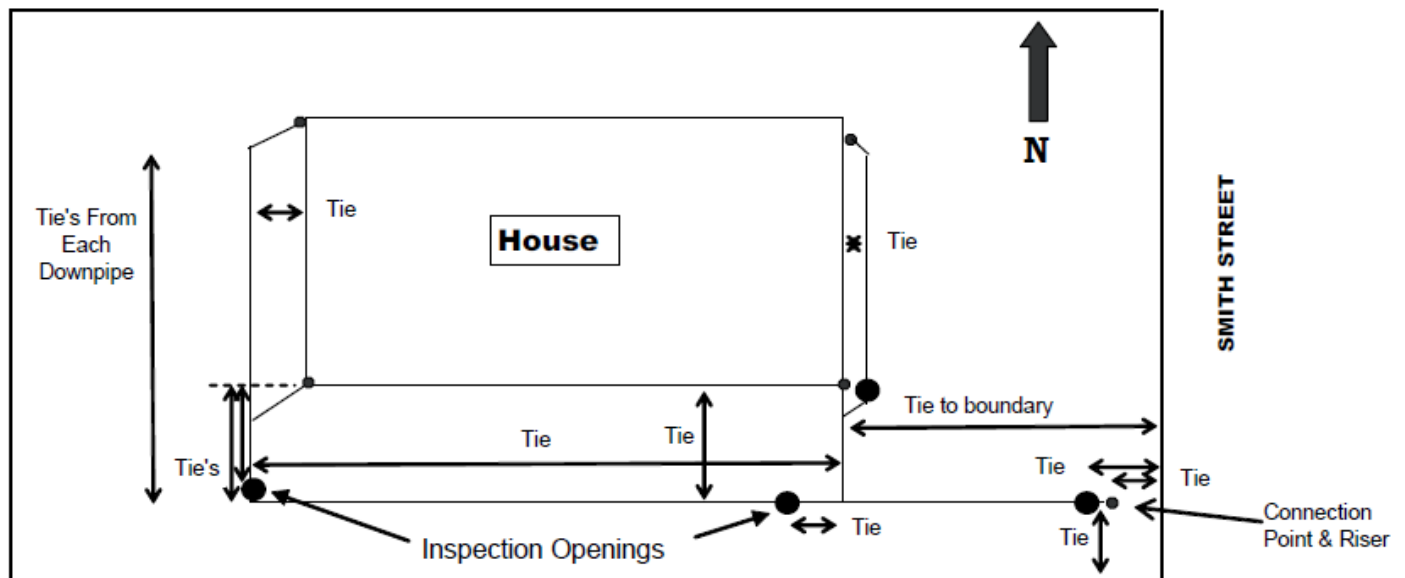

Completed forms can be emailed to [info@wannanwater.com.au](mailto:info@wannanwater.com.au)